


# KENT C.A.E.C.

TILE DRAINAGE SCHEME NO. 72055

ON UNITED WATER WORKS & SUPPLY CO. LTD.  
SEVERELY MANAGED FARMS LTD.

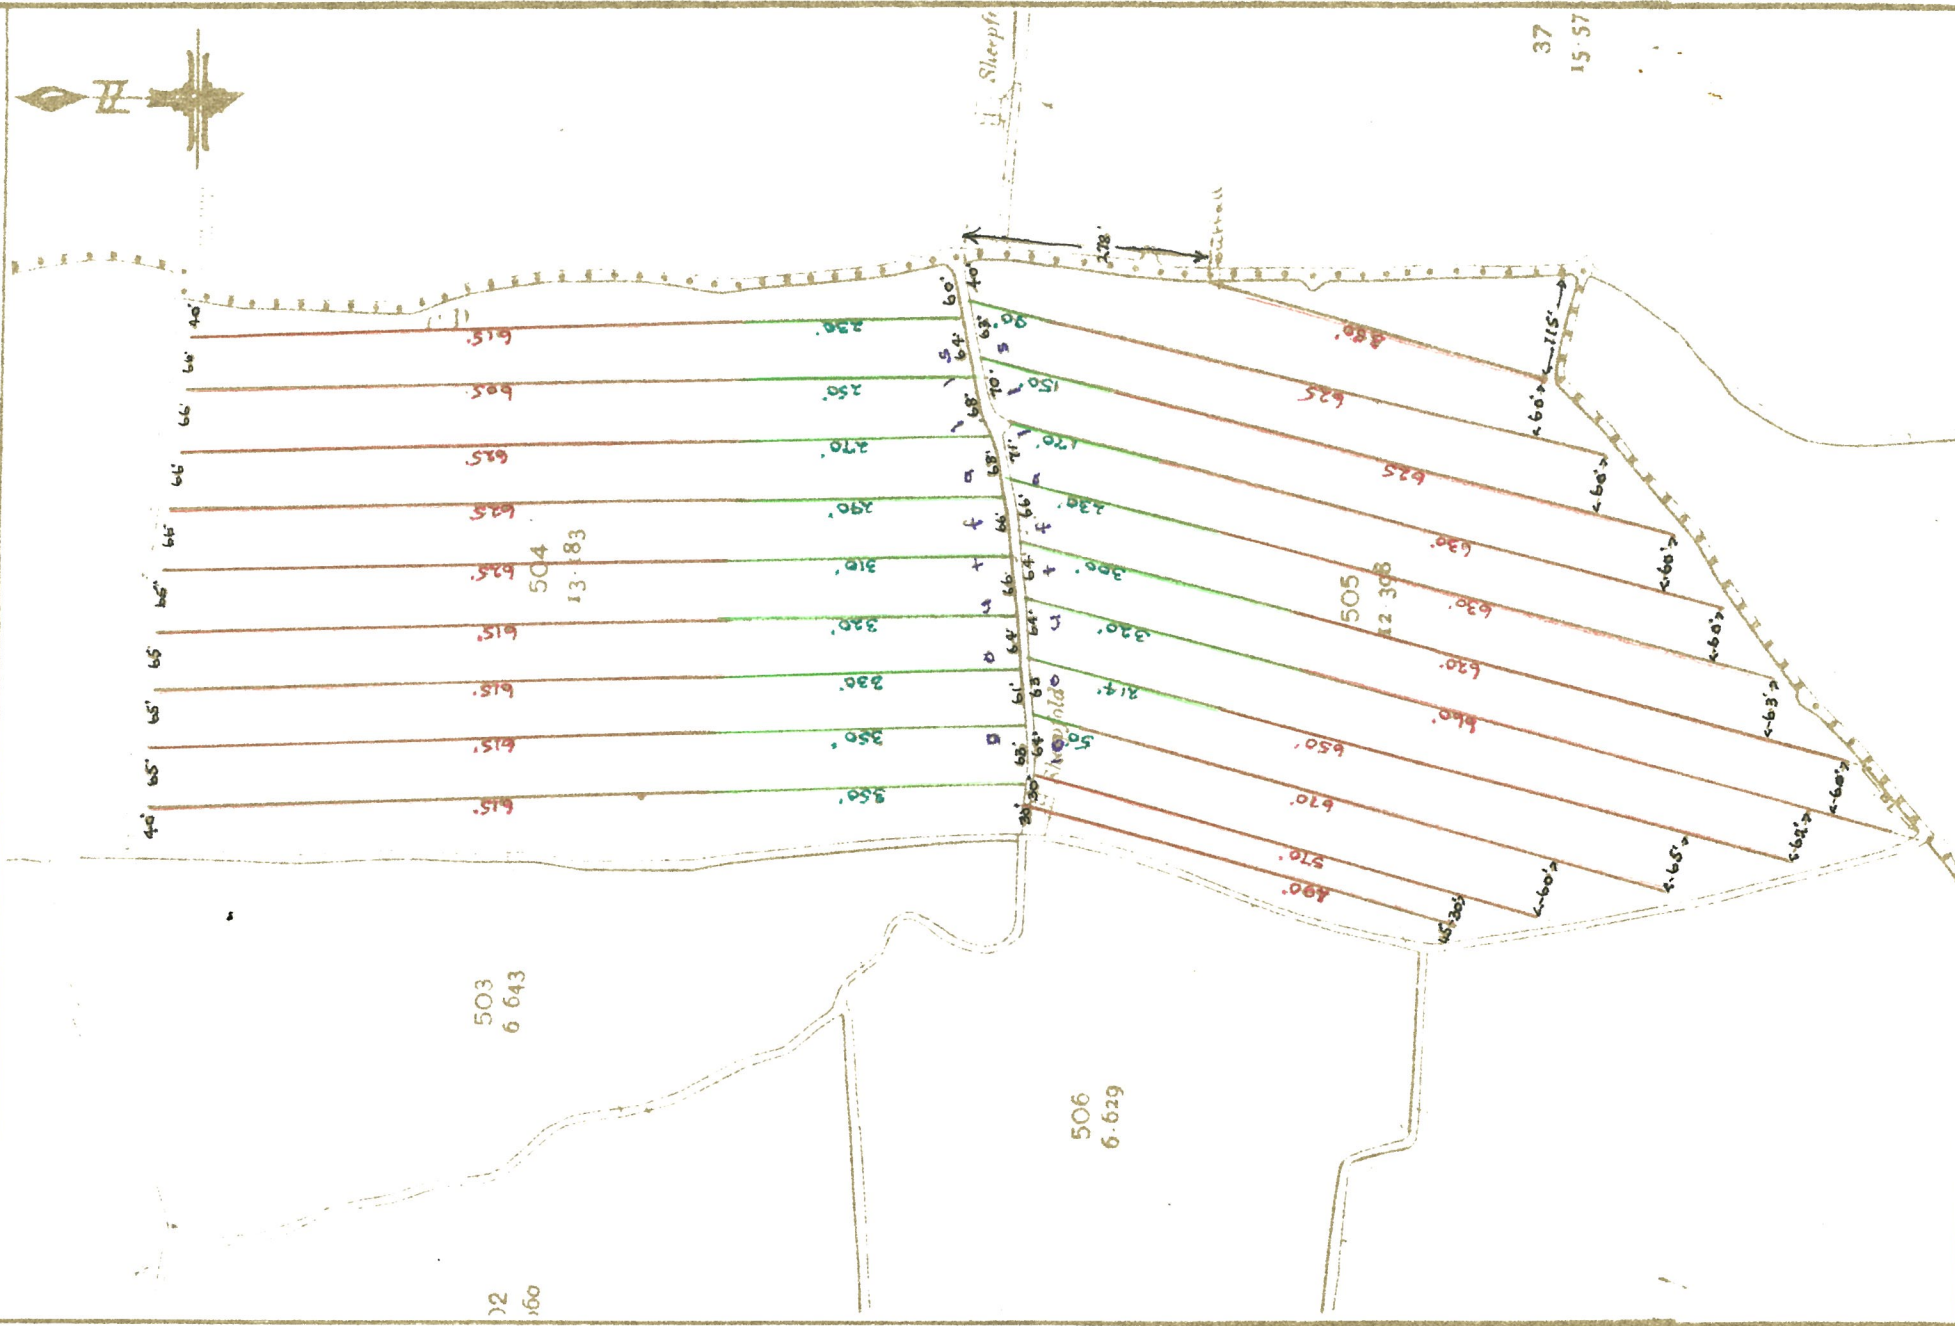

**LEGEND**  
 3" TILE DRAINS SHOWN IN RED  
 4" TILE DRAINS SHOWN IN GREEN  
 6" TILE DRAINS SHOWN IN BLUE

Certified as a true record of the Tile Scheme laid down in Field O.S. Nos 504 and 505 in the Parish of Aldington

*W. C. Small*  
 Chief Officer D.W.S.

KENT SHEET ---  
 EDITION ---  
 SCALE 1/2500

REPRODUCED FROM THE O.S. MAP  
 CROWN COPYRIGHT RESERVED  
 DRAWING NO. 2591